



ZONING APPROVED AS NOTED  
 ALL DEVELOPMENT MUST  
 COMPLY WITH THE PALM  
 BEACH COUNTY UNIFIED LAND  
 DEVELOPMENT CODE (ULDC)  
 4-2-98

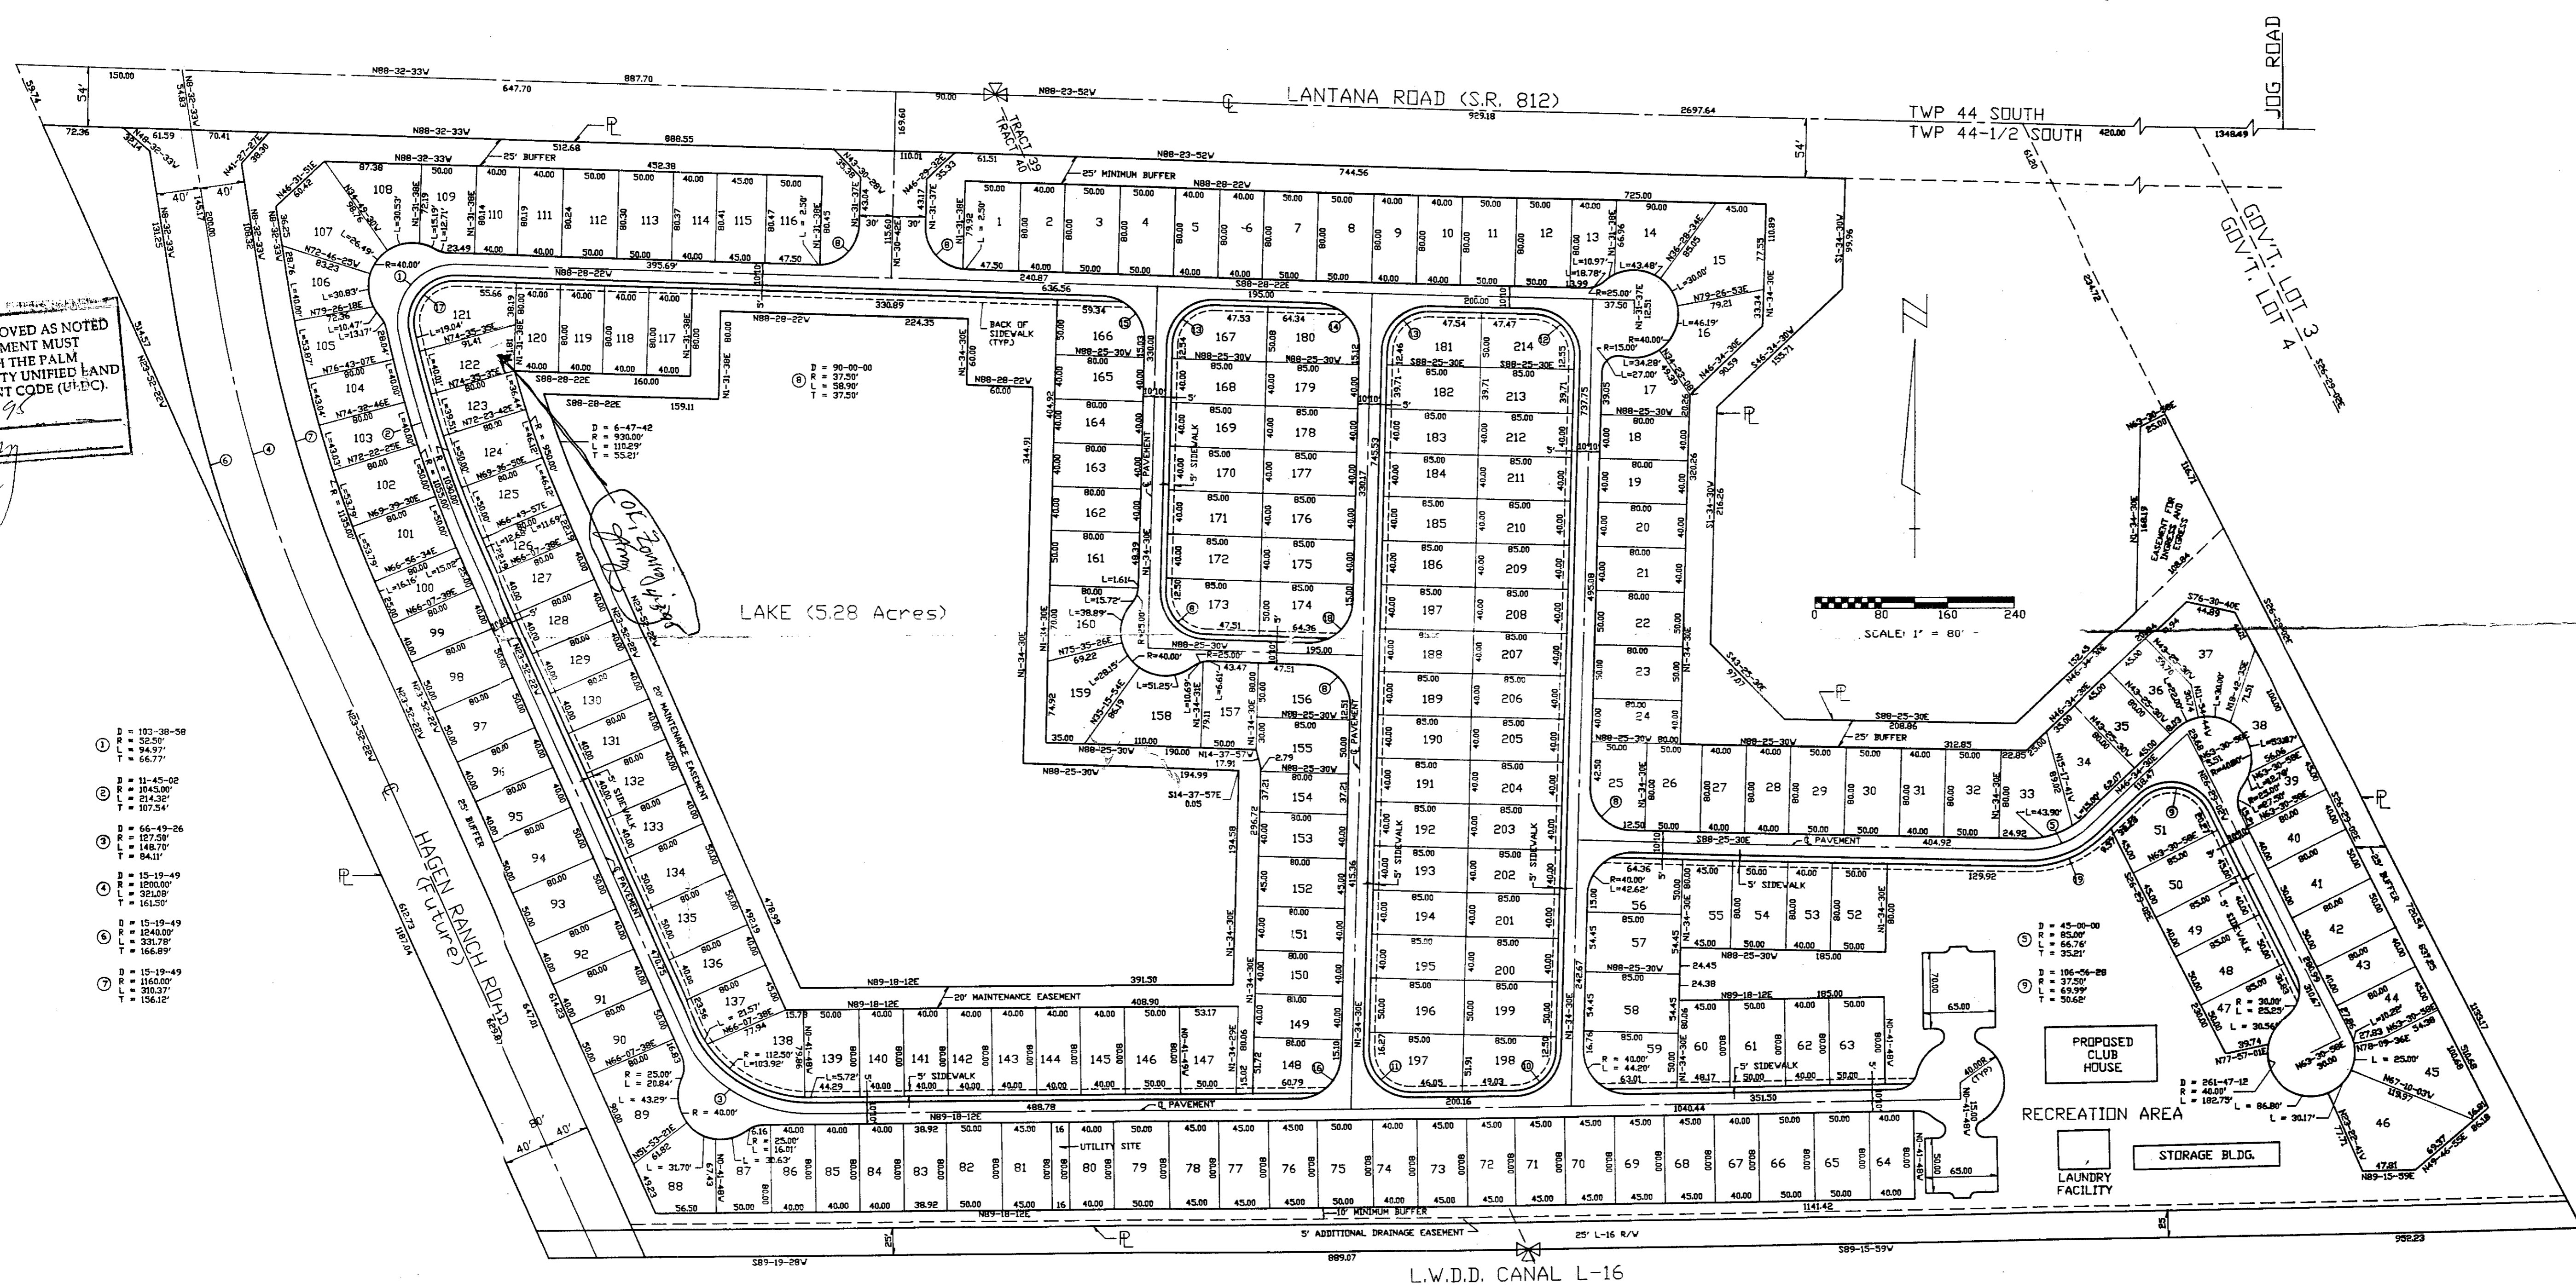

- 1 D = 12-38-88  
T = 52.50'  
R = 54.97'  
L = 66.77'
- 2 D = 11-45-88  
T = 104.50'  
R = 114.20'  
L = 107.54'
- 3 D = 66-49-26  
T = 27.50'  
R = 148.70'  
L = 84.11'
- 4 D = 15-19-49  
T = 100.00'  
R = 152.00'  
L = 161.50'
- 5 D = 15-19-49  
T = 104.00'  
R = 151.78'  
L = 166.89'
- 6 D = 15-19-49  
T = 116.00'  
R = 150.27'  
L = 156.12'

- 18 D = 87-43-42  
T = 37.39'  
R = 57.45'  
L = 36.84'
- 19 D = 92-16-18  
T = 37.50'  
R = 56.29'  
L = 39.02'
- 20 D = 90-02-33  
T = 37.50'  
R = 56.29'  
L = 37.53'
- 21 D = 89-57-07  
T = 37.50'  
R = 56.29'  
L = 37.47'
- 22 D = 61-05-37  
T = 40.00'  
R = 48.83'  
L = 23.61'
- 23 D = 61-05-31  
T = 40.00'  
R = 48.83'  
L = 23.61'
- 24 D = 58-46-24  
T = 40.00'  
R = 48.83'  
L = 23.53'
- 25 D = 103-38-58  
T = 37.50'  
R = 56.29'  
L = 47.70'
- 26 D = 61-02-42  
T = 40.00'  
R = 48.83'  
L = 23.58'
- 27 D = 45-00-00  
T = 37.50'  
R = 100.00'  
L = 114.20'

NO.	DATE	BY	REVISION

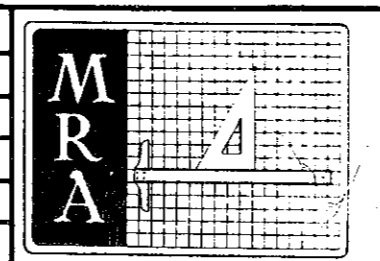

**MOCK, ROOS & ASSOCIATES, INC.**  
 ENGINEERS • SURVEYORS • PLANNERS  
 WEST PALM BEACH, FLORIDA

DATE OF  
 DEC 2 0 1993  
 PRINT  
 SEAL

FIELD:  
 DRAWN: B.H.  
 DESIGNED:  
 APPROVED: T.G.C.  
 SCALE: 1" = 80'

**FEBRUARY 1987 REVISED SITE PLAN  
 PLANTATION AT LANTANA  
 MOBILE HOME RENTAL PARK**

DATE: FEB. 1987  
 P.A. NO. 87-111  
 DR. NO. 44 1/2-42-39-9  
 SHEET 1 OF 1