


DATA BOX

PARK NAME	Sand & Sea
AKA	Sandpaper Cove
PARK ADDRESS	2350 NW 20th Ave, Boynton Bch
USE	DENSITY
PC #	240
ZONING	FLU
ACRES	185
SUBDIVISION #	4500-080
INSPECTION AREA #	7
DATE OF APPROVAL	1987
IMPACT FEE ZONES	502/4
PETITION #	79-25079-293
ZONING QUAD #	19
NUMBER OF SPACES APPROVED	600
ORDINANCE APPROVED UNDER	1987 G
RESOLUTION	
MHP MapID	MHP-09-20
SETBACKS	

DISCLAIMER--
INFORMATIONAL PURPOSES ONLY. The information included in the data box and on the site plan is based solely upon information previously submitted by the applicant.

CORNER RADII = 25 FEET

25 APR. 79	J.B.C. ADDED LOT NUMBERS	FIELD:	B. K.
2 JAN 74	DRW. REVISED LOTS 710 + 690	DRAWN BY:	J.B.C.
23 OCT. 74	J.B.C. ADDED "RECORD DRAWING"	CHECKED BY:	D.H.W.
DATE	BY	DATE:	JULY 1973
	DESCRIPTION	JOB NO.	73 - 56
	REVISION	SEAL	

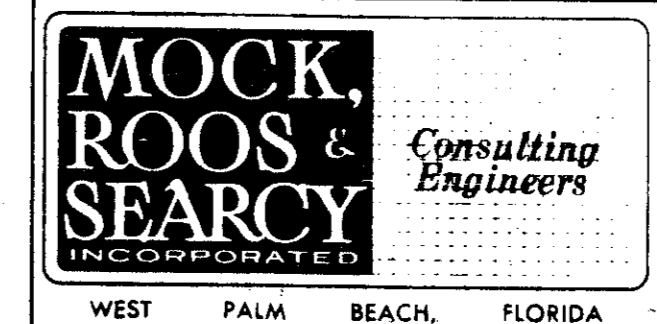

CONTROL SHEET
FOR
SAND & SEA VILLAGE MOBILE HOME COMMUNITY
PALM BEACH COUNTY, FLA.

SCALE: 1" = 60'
DR. NO. 45-43-19-6
SHEET 2 OF 10

"RECORD DRAWING"
PHASE V 242 LOTS