Agenda Item #: 3-C-5

PALM BEACH COUNTY BOARD OF COUNTY COMMISSIONERS **AGENDA ITEM SUMMARY**

Meeting Date: May 5, 2009 [X] Consent [] Regular [] Workshop [] Public Hearing **Department:** Submitted By: Engineering and Public Works Submitted For: Right-of-Way Acquisition Section ______

I. EXECUTIVE BRIEF

Motion and Title: Staff recommends motion to receive and file: A correction to the maintenance limits on Yellow Brick Road, South 19th Drive, and South 19th Avenue.

SUMMARY: On March 17, 2009, the Board approved the maintenance of the above roads with the distance of 112+/- feet, which was in error. Approval of this item will provide for the correct maintenance limit of 211+/- feet for these roads.

District 3 (PK)

Background and Justification: The previous agenda item showed Yellow Brick Road, South 19th Drive, from Yellow Brick Road north 112 feet+/-, and South 19th Avenue, from Yellow Brick Road north 112 feet +/-. The distance of 112 feet +/- is in error. The revised descriptions are, South 19th Drive, from Yellow Brick Road north to the westerly extension of the north line of a parcel identified by Parcel Identification Number (PIN) 00-43-45-00-000-774.7 by the Property Appraiser's Office, as recorded in Official Record Book 18193, page 706; and South 19th Avenue, from Yellow Brick Road north to the westerly extension of the north line of a parcel identified by PIN 00-43-45-04-00-000-771.7 by the Property Appraiser's Office, as recorded in Official Record Book 8165, page 587. The approximate distances are 211 feet. This will provide for the correct maintenance limits of these roads.

Attachments:

1. Location Map 2. Detail Map

Recommended by:					
	Division Director	Date			
Approved by:	S. J. W.M. County Engineer	4/24/09			

7 Date

II. FISCAL IMPACT ANALYSIS

A. Five Year Summary of Fiscal Impact:

Fiscal Years Capital Expenditures Operating Costs External Revenues Program Income (County) In-Kind Match (County) NET FISCAL IMPACT	2009 <u>-0-</u> -0- -0- -0- <u>-0-</u> <u>-0-</u> <u>-0-</u> <u>-0-</u> <u>-0-</u>	2010 0- 0- 0- 0- -0- -0-	2011 0- 0- 0- 0- 0- 0-	2012 -0- -0- -0- -0- -0- -0-	2013
# ADDITIONAL FTE POSITIONS (Cumulative) Is Item Included in Current Budget Acct No.: Fund Progr	Dept	Yes Unit Ob	ject	No <u>.</u>	

B. Recommended Sources of Funds/Summary of Fiscal Impact:

This item has no fiscal impact.

C. Departmental Fiscal Review: _

Contract Dev

and Control

30/09

III. REVIEW COMMENTS

Ç

2

A. OFMB Fiscal and/or Contract Dev. and Control Comments:

B. Approved as to Form and Legal Sufficiency:


5/1 Assistant C anty Attorney

C. Other Department Review:


Department Director

This summary is not to be used as a basis for payment.

I:\WP\AgendaPage2\Agnpgtwo2009\.noimpact

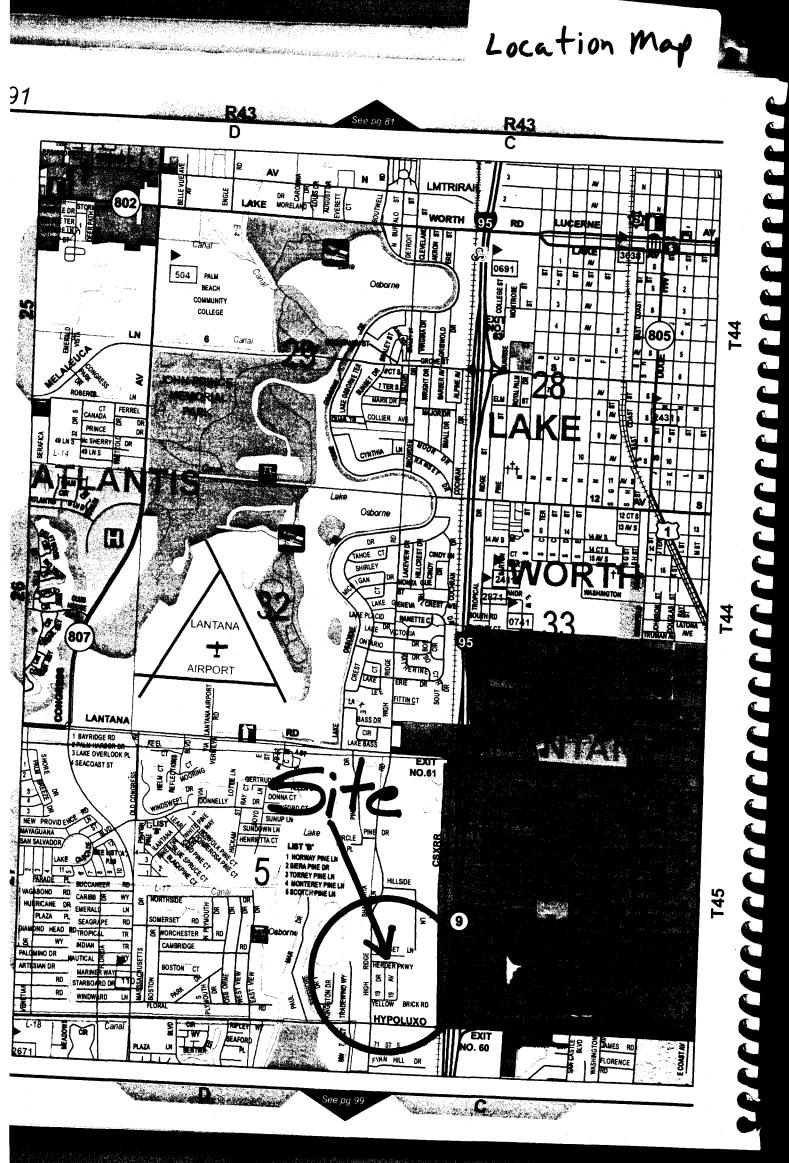

Detail Map

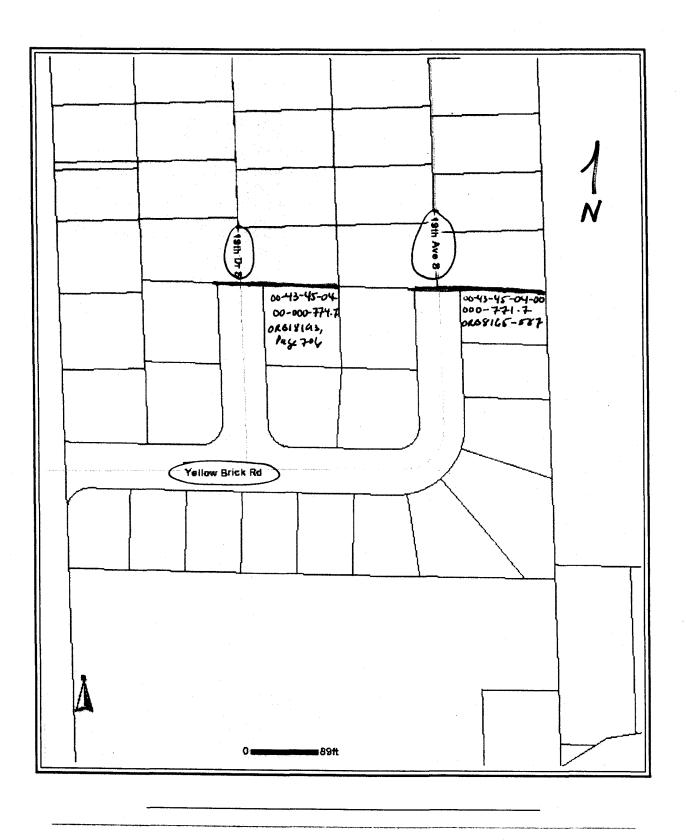

Map Scale 1:1515

Map produced on 3/25/2009

http://cwgisweb.co.palm-beach.fl.us/geonav/presentation/mapping/printnew.asp?MAPUR... 3/25/2009