
☐ Regular
☒ Public Hearing

Submitted By: Engineering and Public Works
Submitted For: Land Development Division

1 2 3 1039 104

1. Location Sketch
2. Resolution with Exhibit 'A'

Approved by: S. T. Wahl Date 10/1/15
County Engineer Date

II. FISCAL IMPACT ANALYSIS

A. Five Year Summary of Fiscal Impact:

Fiscal Years	2016	2017	2018	2019	2020
Capital Expenditures	<u>\$ -0-</u>	<u>-0-</u>	<u>-0-</u>	<u>-0-</u>	<u>-0-</u>
Operating Costs	<u>-0-</u>	<u>-0-</u>	<u>-0-</u>	<u>-0-</u>	<u>-0-</u>
External Revenues	<u>-0-</u>	<u>-0-</u>	<u>-0-</u>	<u>-0-</u>	<u>-0-</u>
Program Income (County)	<u>-0-</u>	<u>-0-</u>	<u>-0-</u>	<u>-0-</u>	<u>-0-</u>
In-Kind Match (County)	<u>-0-</u>	<u>-0-</u>	<u>-0-</u>	<u>-0-</u>	<u>-0-</u>
NET FISCAL IMPACT	<u>\$ **</u>	<u>-0-</u>	<u>-0-</u>	<u>-0-</u>	<u>-0-</u>
# ADDITIONAL FTE					
POSITIONS (Cumulative)					

Is Item Included in Current Budget?	Yes	No
-------------------------------------	-----	----

Budget Acct No.: Fund__ Dept.__ Unit__ Object
Program

Recommended Sources of Funds/Summary of Fiscal Impact:

****This item has no fiscal impact.**

C. Departmental Fiscal Review: Aluikovalainen

III. REVIEW COMMENTS

A. OFMB Fiscal and/or Contract Dev. and Control Comments:

Shen, Ben

Dr. J. Jacobson 10/2/15
Contract Dev. and Control
B. Wheeler 10-2-15


**B. Approved as to Form
and Legal Sufficiency:**

Marlene R. [Signature] 10/6/15
Assistant County Attorney


C. Other Department Review:

Department Director

This summary is not to be used as a basis for payment.

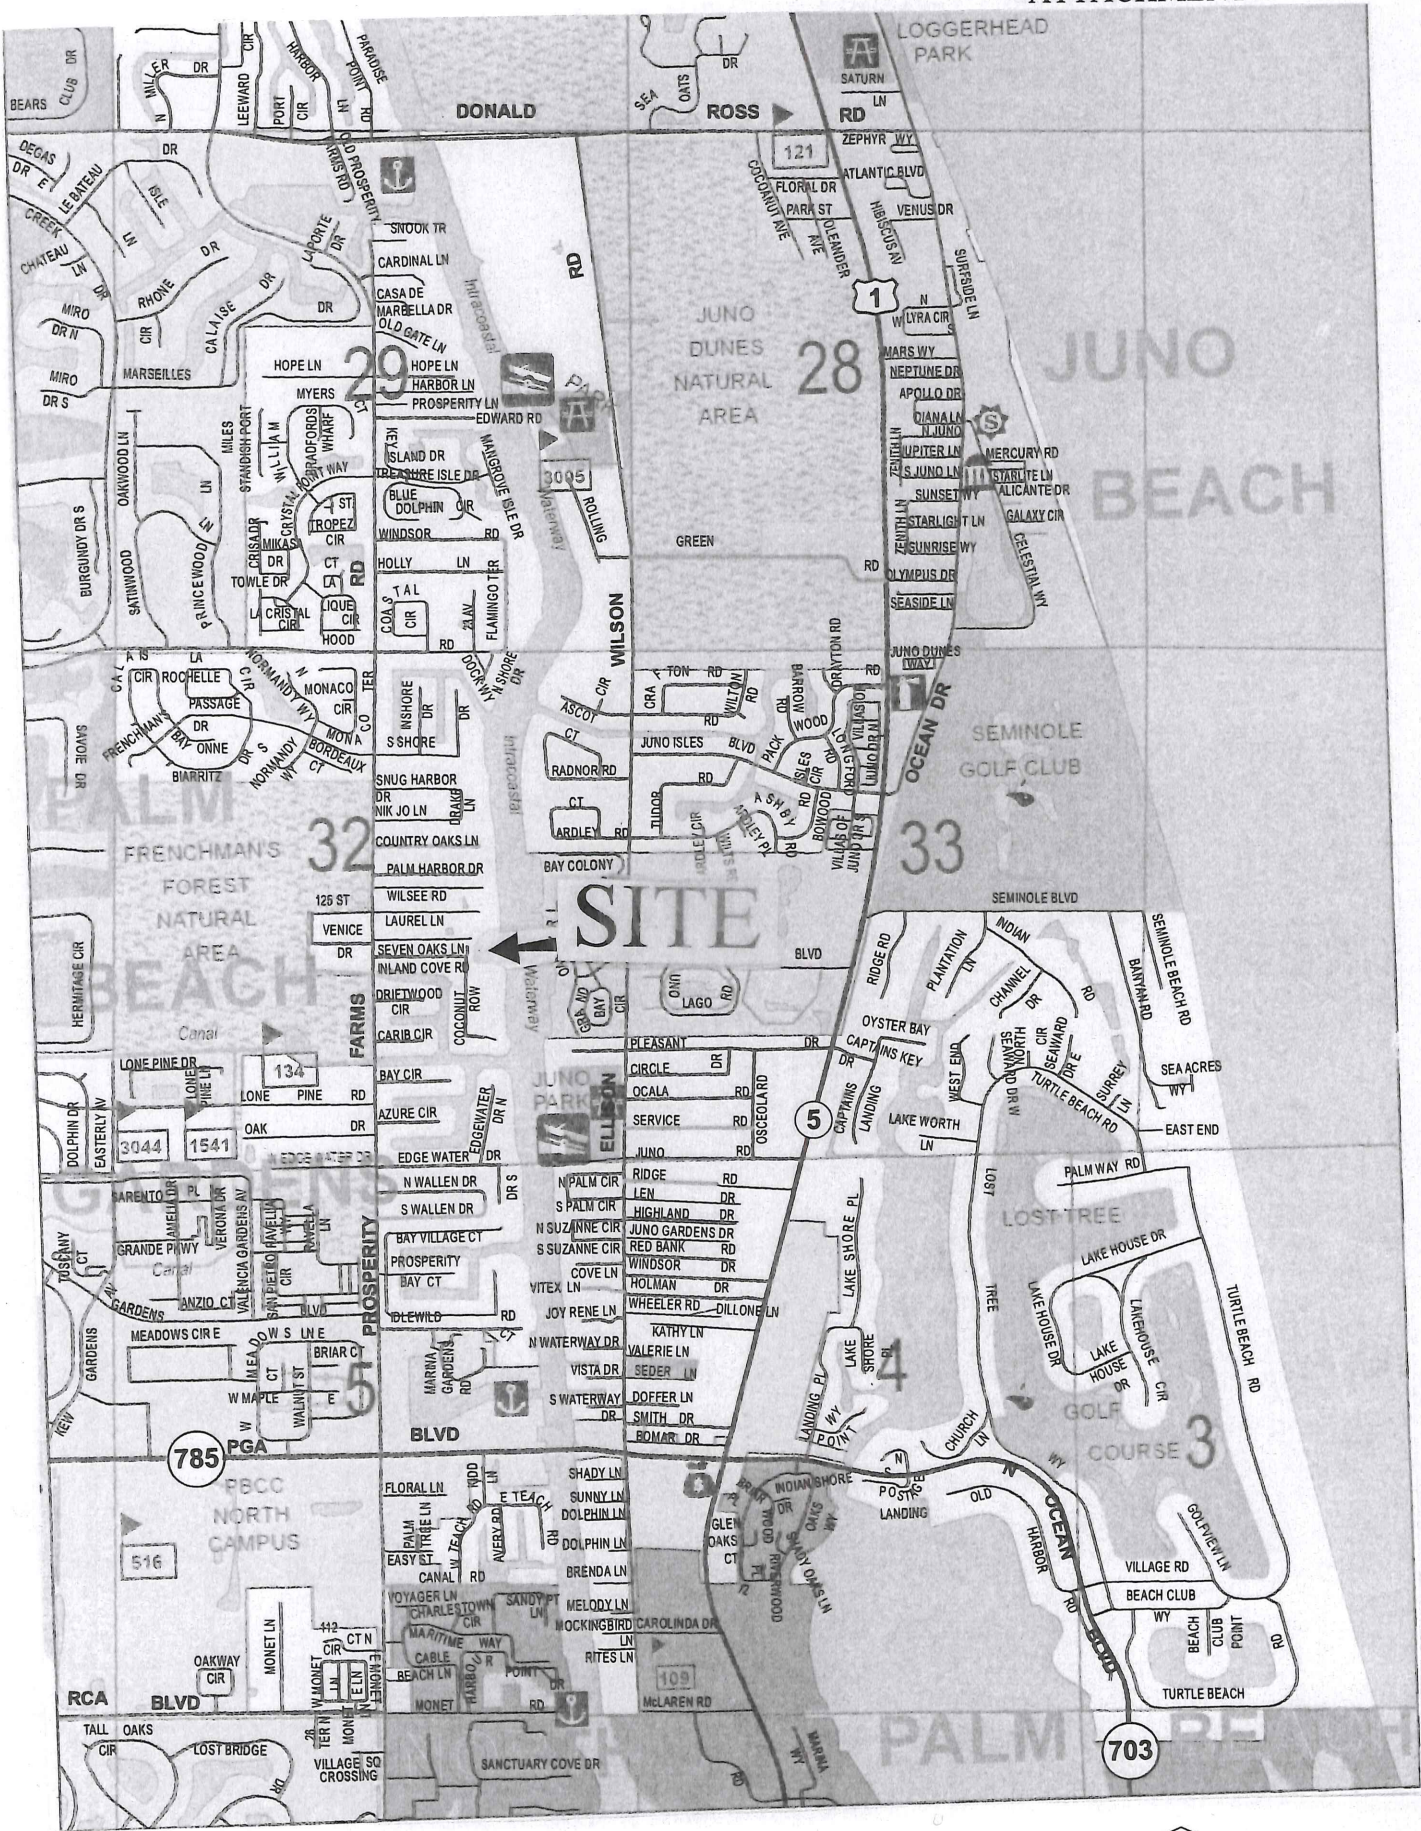

LOCATION SKETCH

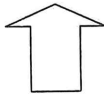

N (Not to scale)

ABANDONMENT OF A PORTION OF A DRAINAGE
EASEMENT WITHIN LOT 2A, SEVEN OAKS REPLAT OF LOTS
1 AND 2, PLAT BOOK 74, PAGE 196, PUBLIC RECORDS,
PALM BEACH COUNTY, FLORIDA

RESOLUTION NO. R-2015-_____

RESOLUTION OF THE BOARD OF COUNTY COMMISSIONERS OF PALM BEACH COUNTY, FLORIDA, VACATING A FIVE TO TEN FOOT PORTION OF A FIFTEEN FOOT WIDE DRAINAGE EASEMENT LYING IN LOT 2A, SEVEN OAKS REPLAT OF LOTS 1 AND 2, ACCORDING TO THE PLAT THEREOF, AS RECORDED IN PLAT BOOK 74, PAGE 196, OF THE PUBLIC RECORDS OF PALM BEACH COUNTY, FLORIDA.

WHEREAS, the Board of County Commissioners of Palm Beach County, Florida (Board), has considered the vacation pursuant to authority in Sections 177.101 and 336.09 of the Florida Statutes and as provided in Palm Beach County (County) Code Chapter 22. Article III, Road Abandonment and Plat Vacation (Ordinance No. 2002-034) for the vacation of the hereinafter described; and

WHEREAS, petition to vacate a five to ten foot portion of the 15 foot drainage easement lying in Lot 2A, Seven Oaks Replat of Lots 1 and 2 was submitted by Michael J. and Maria R. Zappa; and

WHEREAS, this petition substantially complies with the terms and conditions of the vacation as set forth in said Ordinance; and

WHEREAS, this Board, while convened in regular session on October 20, 2015, did hold a meeting on said petition to vacate, and this Board determined that said portion of the 15 foot drainage easement lying in Lot 2A, as shown in Exhibit A, is in excess of the requirements of the local utility companies; and

WHEREAS, this Board while convened in regular session on October 20, 2015, did hold a meeting on said Petition to abandon/vacate that said portion of the 15 foot drainage easement lying in Lot 2A, shown in Exhibit A, and this Board determined that said abandonment/vacation conforms to the County's Land Development Code.

RESOLUTION NO. R-2015-_____

NOW, THEREFORE, BE IT RESOLVED BY THE BOARD OF COUNTY COMMISSIONERS OF PALM BEACH COUNTY, FLORIDA, that:

1. The foregoing recitals are hereby reaffirmed and ratified.
2. A five to ten foot portion of the 15 foot drainage easement lying in Lot 2A is hereby vacated and closed as a public easement and this Board does hereby renounce and disclaim any right or interest of the County and the Public in and to the easement, more fully described in the legal description and sketch as shown in Exhibit A attached hereto and made a part hereof.
3. Notice of the adoption of this Resolution shall be published once in the Palm Beach Post within 30 days of the date of adoption of this Resolution as provided in Palm Beach County Code Chapter 22. Article III, Road Abandonment and Plat Vacation (Ordinance 2002-034).

RESOLUTION NO. R-2015-_____

The foregoing Resolution was offered by Commissioner _____,
who moved its adoption. The motion was seconded by
Commissioner_____ and, upon being put to a vote, the vote was as
follows:

Commissioner Shelley Vana, Mayor

Commissioner Mary Lou Berger, Vice Mayor

Commissioner Hal R. Valeche

Commissioner Paulette Burdick

Commissioner Steven L. Abrams

Commissioner Melissa McKinlay

Commissioner Priscilla A. Taylor

The Mayor thereupon declared the Resolution duly passed and adopted
this _____ day of _____, 2015.

**PALM BEACH COUNTY, FLORIDA, BY ITS
BOARD OF COUNTY COMMISSIONERS**

Sharon R. Bock, Clerk & Comptroller

BY: _____
Deputy Clerk

**APPROVED AS TO FORM AND
LEGAL SUFFICIENCY**

BY: _____
County Attorney

EXHIBIT A

Page 1 of 5

LEGAL DESCRIPTION: A PARCEL OF LAND BEING A PORTION OF THE 15.00 FOOT WIDE DRAINAGE EASEMENT LYING IN LOT 2A, SEVEN OAKS REPLAT OF LOTS 1 AND 2, ACCORDING TO THE PLAT THEREOF, AS RECORDED IN PLAT BOOK 74, PAGE 196, PUBLIC RECORDS, PALM BEACH COUNTY, FLORIDA. SAID PARCEL OF LAND BEING MORE PARTICULARLY DESCRIBED AS FOLLOWS:

COMMENCE AT THE NORTHWEST CORNER OF SAID LOT 2A; THENCE, NORTH 89°25'07" EAST, ALONG THE NORTH LINE OF SAID LOT, A DISTANCE OF 217.69 FEET; THENCE, SOUTH 00°34'53" EAST, DEPARTING SAID NORTH LINE, A DISTANCE OF 6.47 FEET TO THE **POINT OF BEGINNING**;

THENCE, CONTINUE SOUTH 00°34'53" EAST, A DISTANCE OF 8.53 FEET TO THE SOUTH LINE OF SAID EASEMENT; THENCE, NORTH 89°25'07" EAST, ALONG SAID SOUTH LINE, A DISTANCE OF 208.48 FEET; THENCE, NORTH 00°27'52" WEST, DEPARTING SAID SOUTH LINE, A DISTANCE OF 8.10 FEET; THENCE, SOUTH 89°32'08" WEST, A DISTANCE OF 208.50 FEET TO THE **POINT OF BEGINNING**.

CONTAINING: 1,733 SQUARE FEET OR 0.04 ACRE, MORE OR LESS.

SURVEYOR'S NOTES:

1. NO BELOW GROUND IMPROVEMENTS/STRUCTURES, IF ANY, HAVE BEEN LOCATED.
2. THE EASEMENTS SHOWN HEREON ARE PER THE PLAT OF SEVEN OAKS, PLAT BOOK 50, PAGE 120, AND AS SHOWN ON SEVEN OAKS REPLAT OF LOTS 1 AND 2, PLAT BOOK 74, PAGE 196, UNLESS NOTED OTHERWISE.
3. THE N & E COORDINATES SHOWN HEREON ARE BASED ON THE COORDINATES FOR THE NORTH LINE OF LOT 2A, AS SHOWN ON SEVEN OAKS REPLAT OF LOTS 1 AND 2, PLAT BOOK 74, PAGE 196, AND ARE STATE PLANE GRID COORDINATES ACCORDING TO THE TRANSVERSE MERCATOR PROJECTION OF THE FLORIDA EAST ZONE, N.A.D. 83, PER THE 1990 ADJUSTMENT.
4. THE LINEAR DIMENSIONS SHOWN HEREON ARE GROUND DISTANCES IN U.S. FEET AND DECIMAL PARTS THEREOF.
5. THE GROUND DISTANCE TO GRID DISTANCE SCALE FACTOR IS 1.000048024 (GROUND DISTANCE x SCALE FACTOR = GRID DISTANCE)
6. NO SEARCH OF THE PUBLIC RECORDS WERE PERFORMED BY THIS OFFICE.
7. ELEVATIONS SHOWN HEREON ARE EXPRESSED IN FEET AND DECIMAL PARTS THEREOF, AND BASED UPON AN ELEVATION OF 11.64 (NGVD29) ON THE FINISHED FLOOR OF THE RESIDENCE SHOWN HEREON, AS SHOWN ON THE TOPOGRAPHIC SURVEY PREPARED BY DONALD D. DANIELS HAVING DRAWING NUMBER 02-029.10, LAST REVISED 9/27/06.
8. THE BEARING BASIS (BB) AS SHOWN HEREON, IS BASED ON THE PLATTED BEARING OF NORTH 89°25'07" EAST ALONG THE NORTH LINE OF LOT 2A, AS SHOWN HEREON, AND ALL OTHER BEARINGS ARE RELATIVE THERETO. BEARING ROTATION PLAT TO GRID IS 02°30'50" (CLOCKWISE):

NORTH LINE OF LOT 2A N89°25'07"E (PLAT)
S88°04'03"E (GRID)

CERTIFICATION: I HEREBY CERTIFY THAT THIS SPECIFIC PURPOSE SURVEY AS SHOWN HEREON WAS PREPARED FOR A PARTIAL DRAINAGE EASEMENT ABANDONMENT, THAT THIS SKETCH OF SURVEY IS TRUE AND CORRECT TO THE BEST OF MY KNOWLEDGE AND BELIEF, AND THAT THIS SURVEY COMPLIES WITH THE APPLICABLE MINIMUM TECHNICAL STANDARDS AS SET FORTH IN CHAPTER 5J-17, FLORIDA ADMINISTRATIVE CODE.

2-20-2014
DATE OF FIELD SURVEY

NAME: Stephen L. Shirley
STEPHEN L. SHIRLEY, P.S.M. 3918

THIS SURVEY IS NOT VALID WITHOUT THE SIGNATURE AND THE ORIGINAL RAISED SEAL OF A FLORIDA LICENSED SURVEYOR AND MAPPER. SEE SHEETS 2 THROUGH 5 OF 5 FOR SURVEY MAP


SPECIFIC PURPOSE SURVEY OF: REVISD:10/19/13; 2/20/14; 5/8/14; 5/6/14; 6/8/15; 7/10/15;8/13/15
PORTION OF 15.00' DRAINAGE EASEMENT TO BE ABANDONED
LOT 2A, SEVEN OAKS REPLAT OF LOTS 1 AND 2



ASSOCIATED LAND SURVEYORS, INC.
4152 W. BLUE HERON BLVD. SUITE 121
RIVIERA BEACH, FLORIDA 33404

PHONE: (561) 848-2102 FAX: (561) 844-9659 LB NO. 7344 EMAIL: als@alssurvey.net

FILE: 13-0035-ABANDON | DATE: 2/20/2014 | BY: BLS | CKD: | W.O.NO.: 13-0035 | SHEET: 1 OF 5

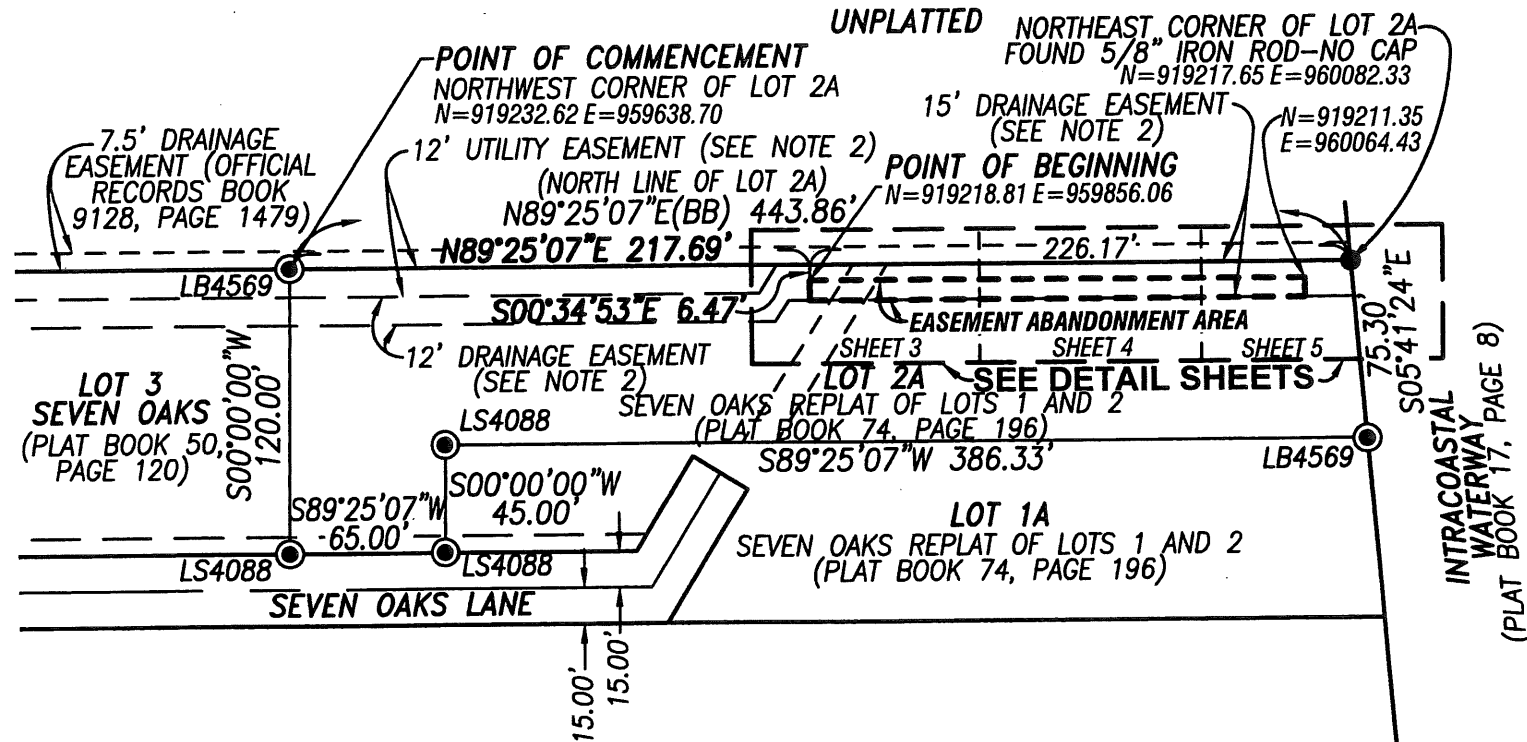

LEGEND:

● = 5/8" CAPPED IRON ROD



0 40' 80'
GRAPHIC SCALE
(IN FEET)

SEE SHEET 1 OF 5 FOR CERTIFICATION, LEGAL DESCRIPTION AND SURVEYOR'S NOTES

SPECIFIC PURPOSE SURVEY OF:

REVISED: 10/19/13; 2/20/14; 5/8/14; 5/6/14; 6/8/15; 7/10/15; 8/13/15

PORTION OF 15.00' DRAINAGE EASEMENT TO BE ABANDONED
LOT 2A, SEVEN OAKS REPLAT OF LOTS 1 AND 2




ASSOCIATED LAND SURVEYORS, INC.

4152 W. BLUE HERON BLVD. SUITE 121
RIVIERA BEACH, FLORIDA 33404

PHONE: (561) 848-2102 FAX: (561) 844-9659 LB NO. 7344 EMAIL: als@alssurvey.net

FILE: 13-0035-ABANDON | DATE: 2/20/2014 | BY: BLS | CKD: | W.O.NO.: 13-0035 | SHEET: 2 OF 5

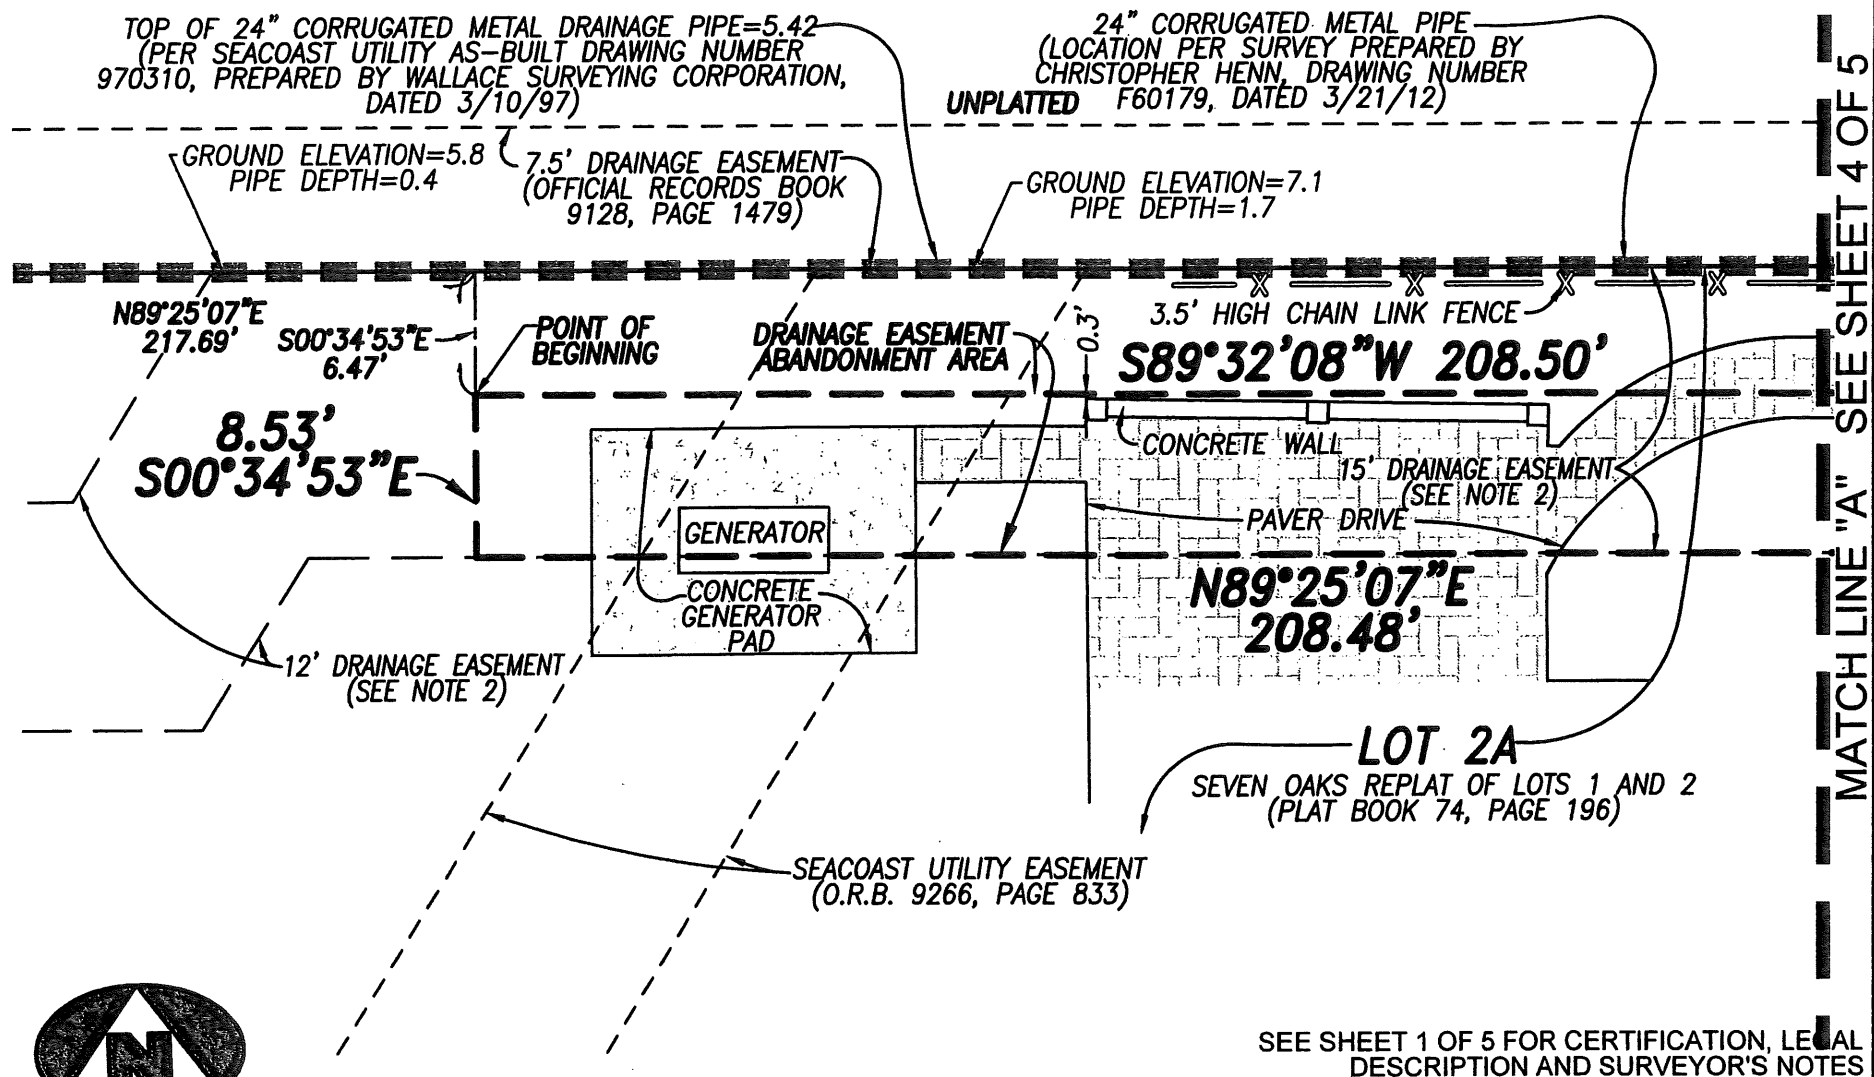


0 5' 10'

GRAPHIC SCALE
(IN FEET)

SEE SHEET 1 OF 5 FOR CERTIFICATION, LEGAL
DESCRIPTION AND SURVEYOR'S NOTES

SPECIFIC PURPOSE SURVEY OF: REVISED: 10/19/13; 2/20/14; 5/8/14; 5/6/14; 6/8/15; 7/10/15; 8/13/15
PORTION OF 15.00' DRAINAGE EASEMENT TO BE ABANDONED
LOT 2A, SEVEN OAKS REPLAT OF LOTS 1 AND 2

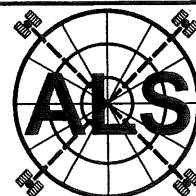

ASSOCIATED LAND SURVEYORS, INC.
4152 W. BLUE HERON BLVD. SUITE 121
RIVIERA BEACH, FLORIDA 33404

PHONE: (561) 848-2102 FAX: (561) 844-9659 LB NO. 7344 EMAIL: als@alssurvey.net

FILE: 13-0035-ABANDON DATE: 2/20/2014 BY: BLS CKD: W.O.NO.: 13-0035 SHEET: 3 OF 5

