


by phone 19651007
G. Moore, City Attorney for Boynton Beach
interprets Exception in Chapt 61-188B as
meaning only that portion of ~~the~~ the NE 1/4
of Sec 4 - 46/43 as ~~that~~ Area colored yellow ☐

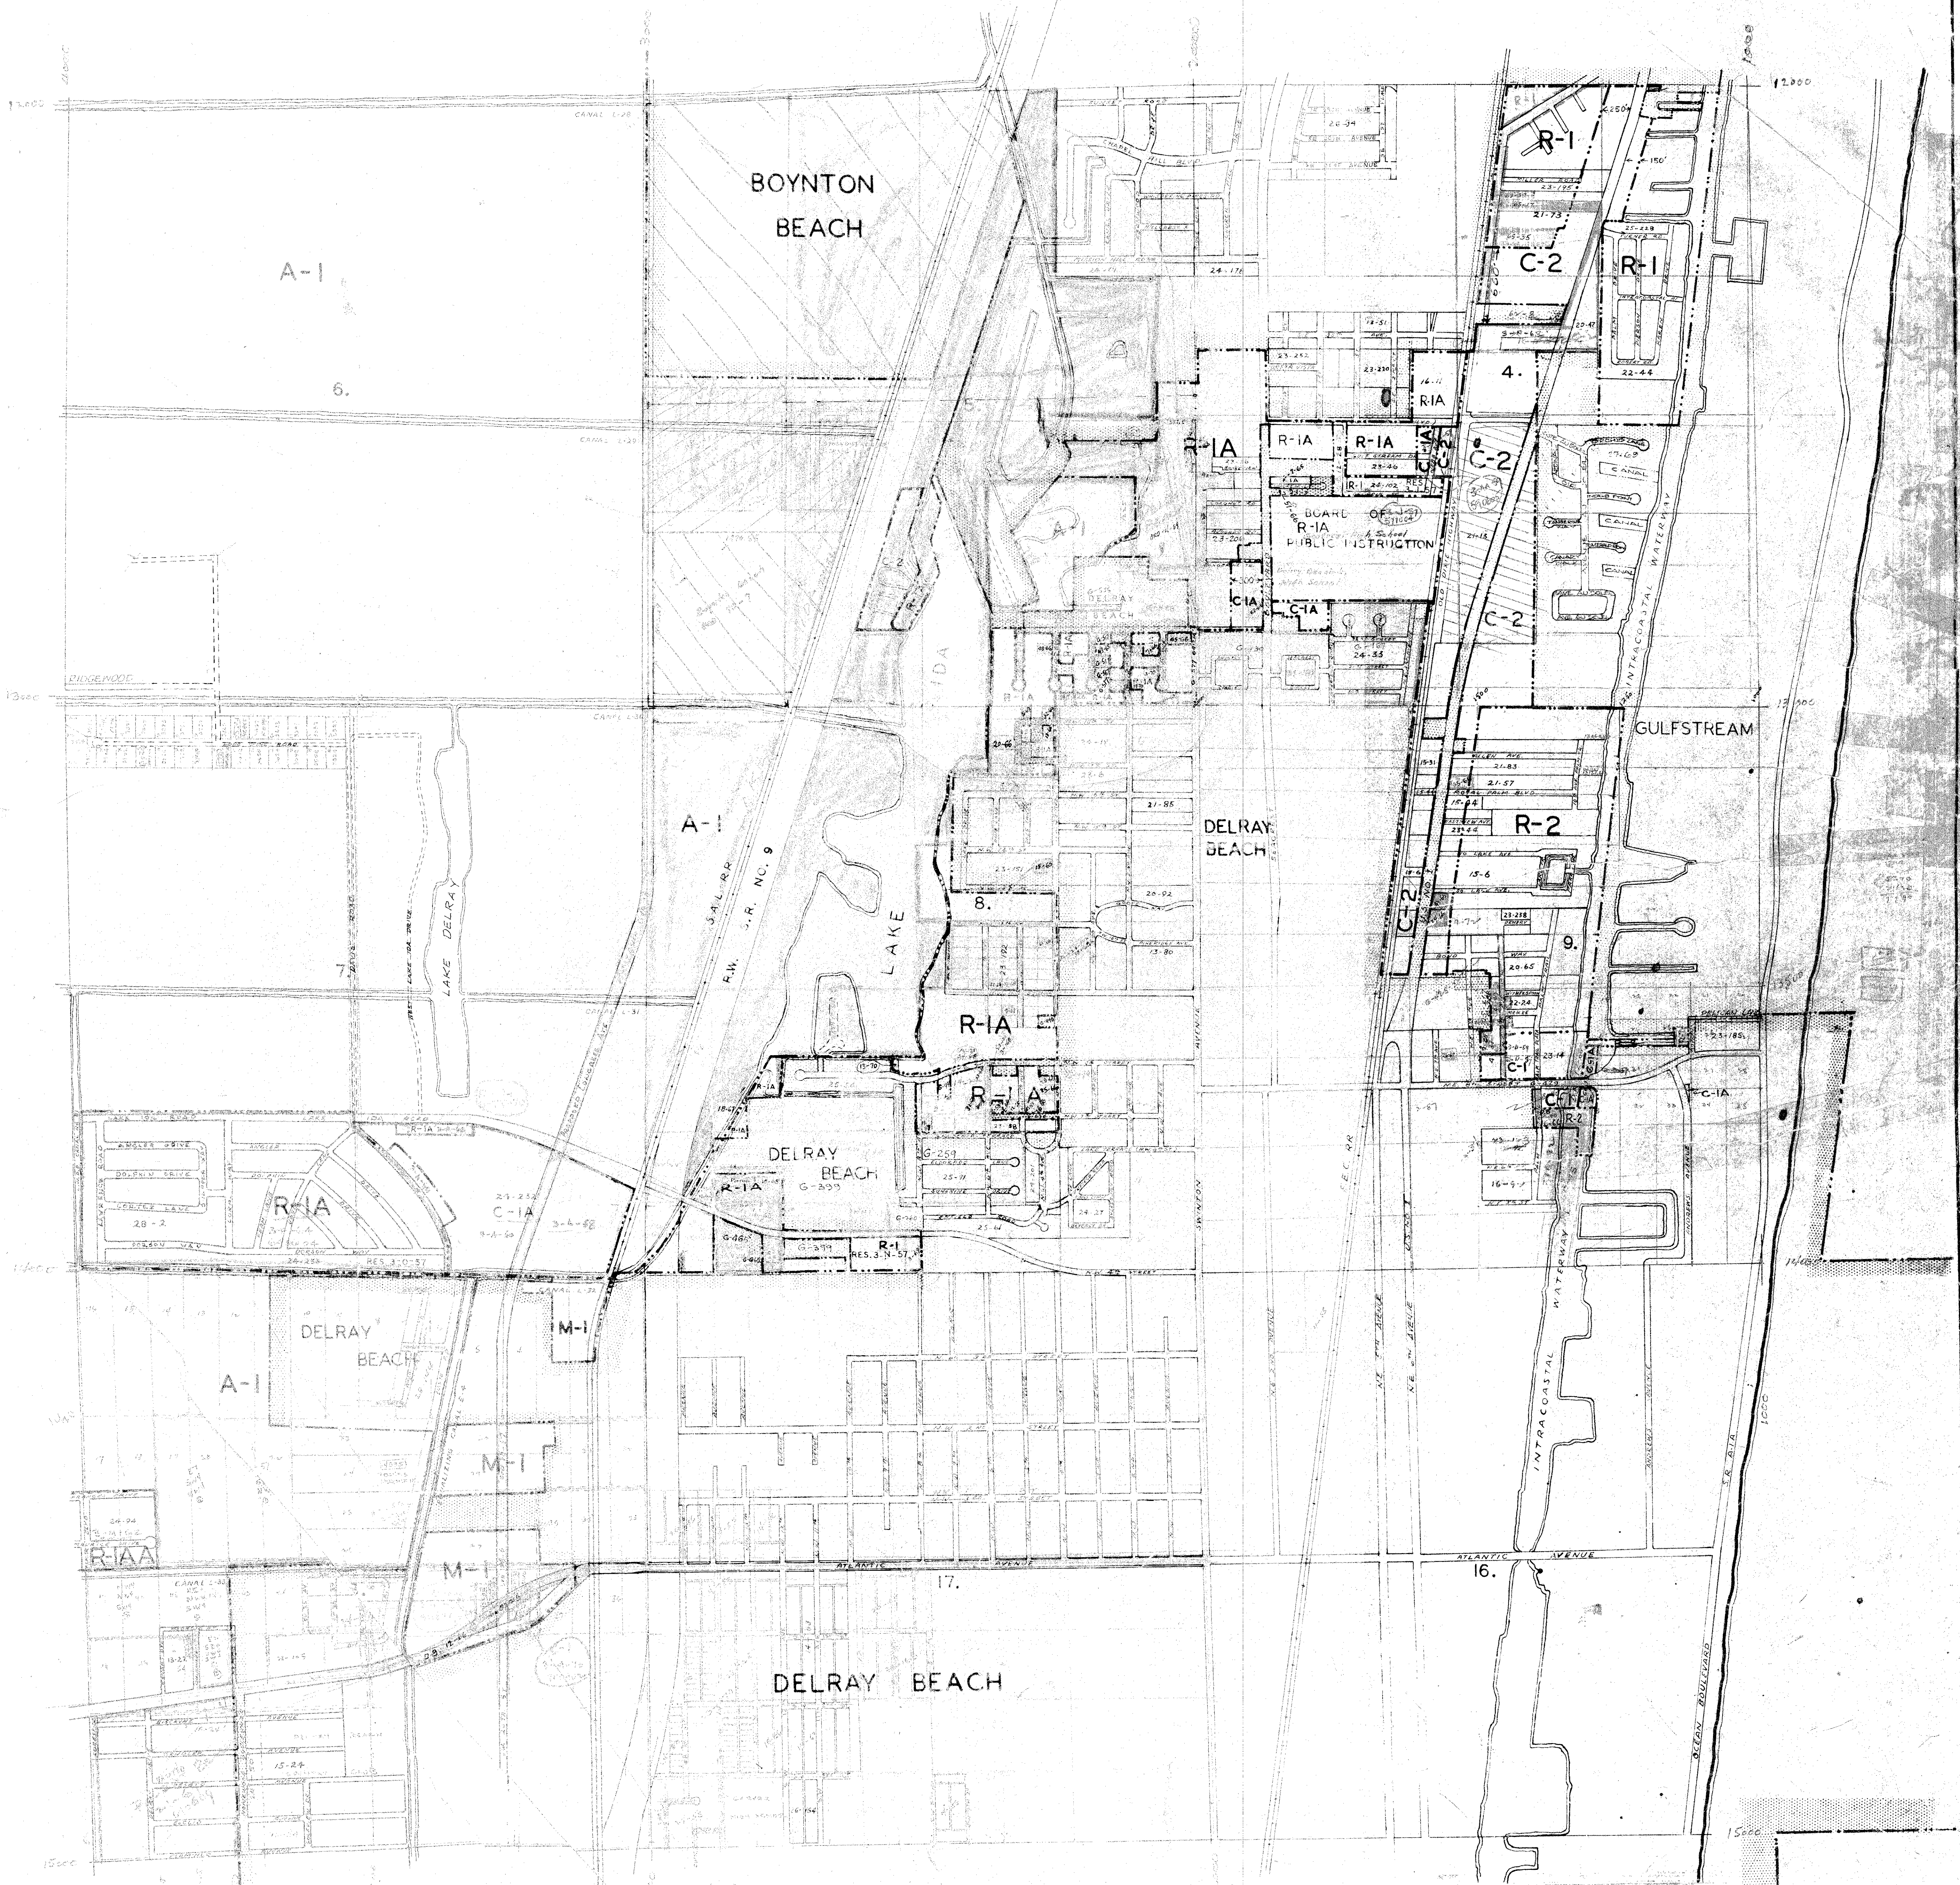

REVISED 7-1-57
REVISED 10-4-57
REVISED 9-1-58
REVISED 10-3-58
REVISED 1-7-60
REVISED 5-23-60

PALM BEACH COUNTY, FLORIDA
 GENERAL DISTRICT MAP
 SCALE: 1" = 600' DATE: 3-1-57
 DRAWN BY: 4643-B CHECKED BY: C-21
 APPROVED BY: RJJ
 DISTRICT BOUNDARIES
 CORPORATE BOUNDARIES

464324 C-21