GRAPHIC SCALE

20 0 20 40

(IN FEET)
1 inch = 20 ft.

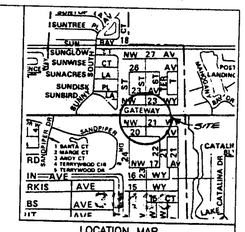

LOCATION MAP
N.T.S.

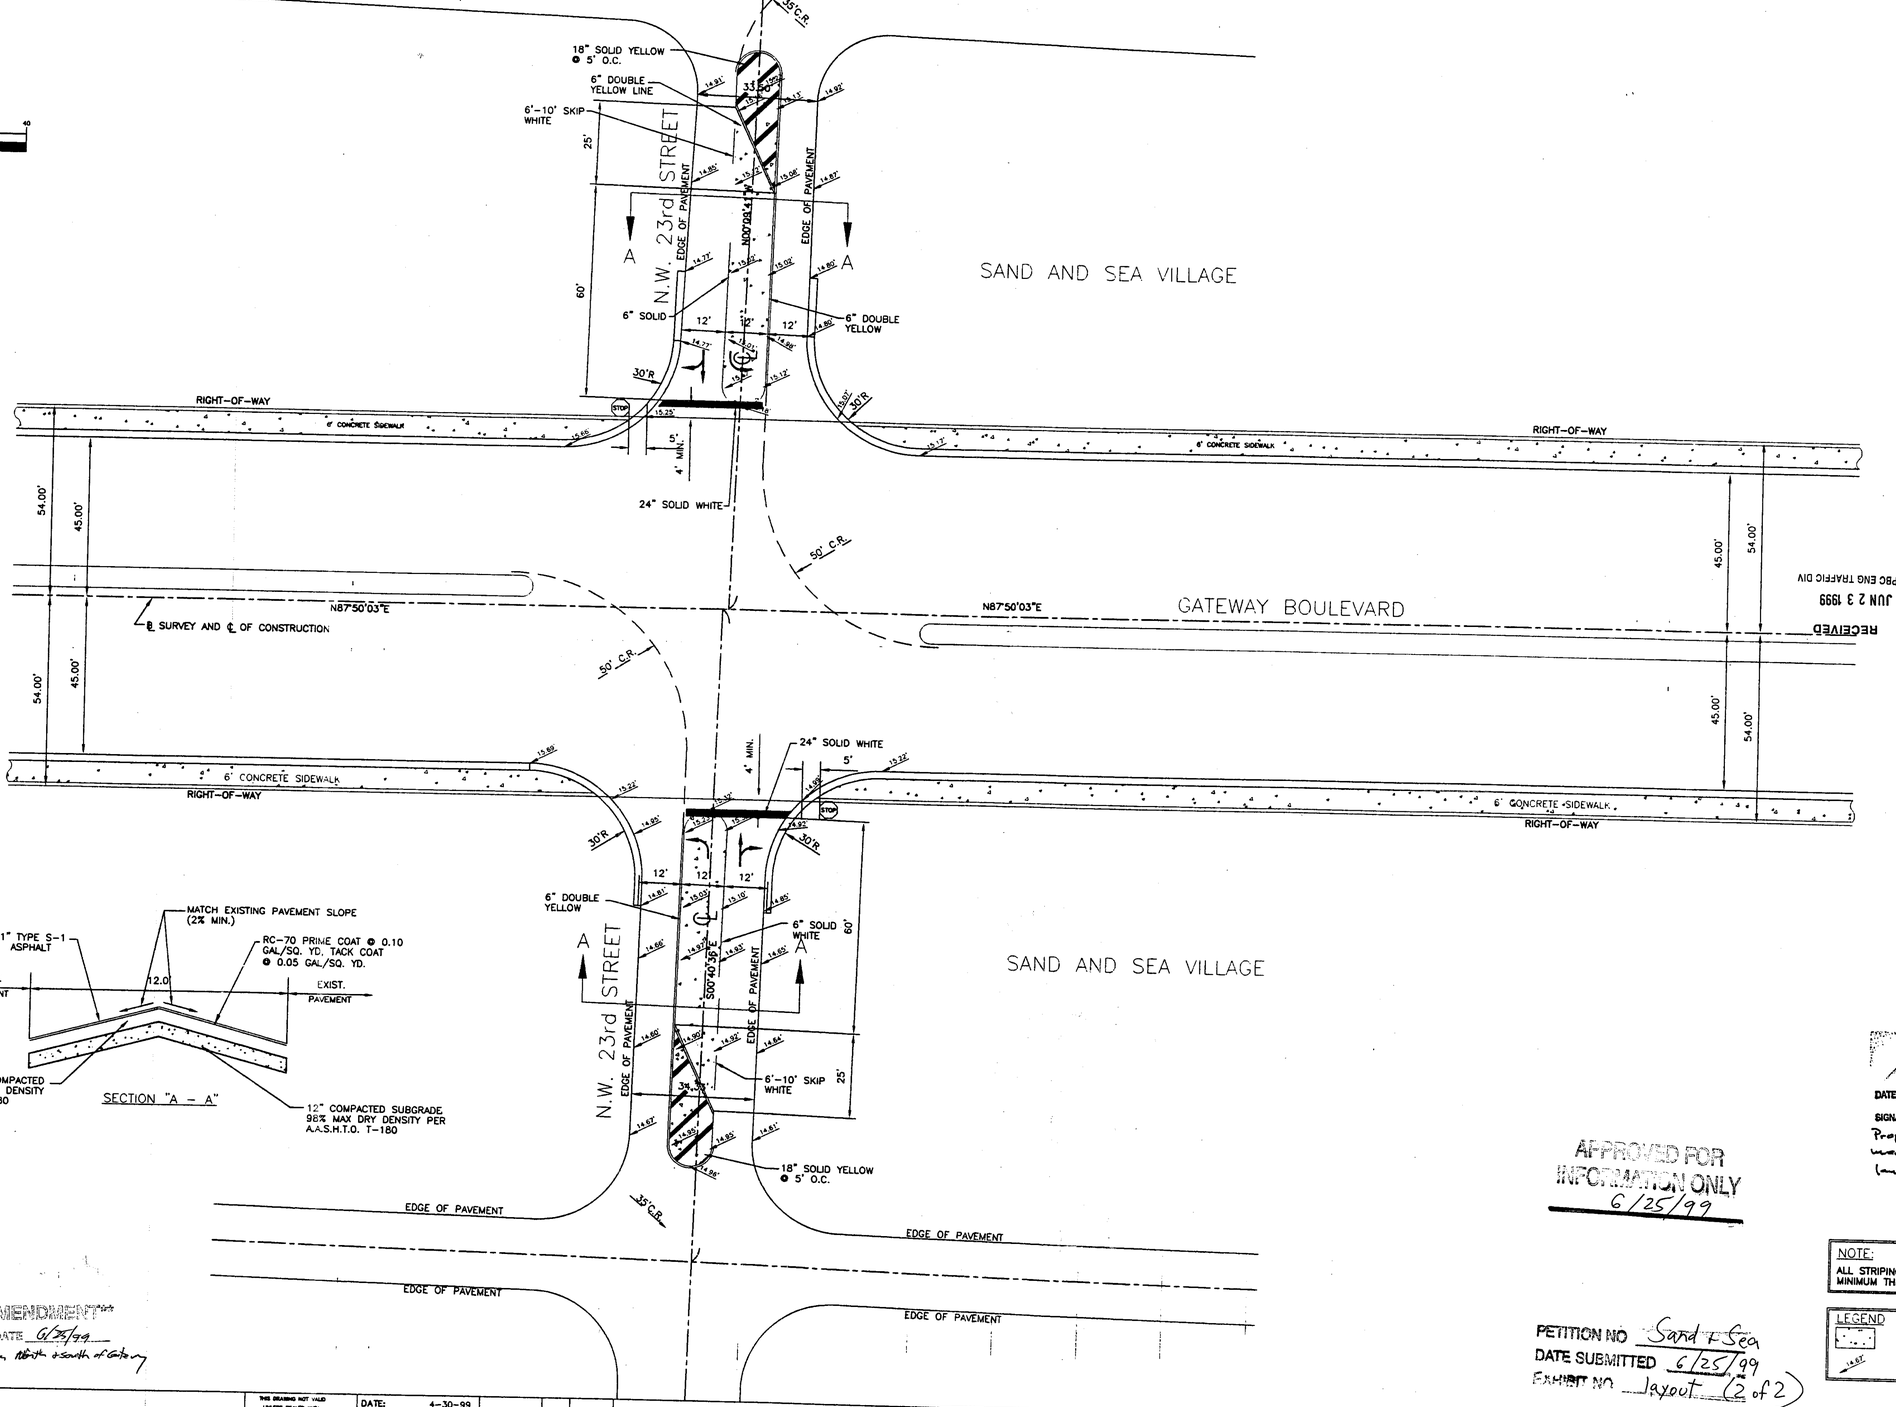

RECEIVED
JUN 23 1999
PBC ENG TRAFFIC DIV

APPROVED AS NOTED
PALM BEACH COUNTY
TRAFFIC DIVISION
DATE: 6-24-99
SIGNATURE:
Proposed to pave existing entrance medians for use as left turn lanes.

APPROVED FOR INFORMATION ONLY
6/25/99

ADMINISTRATIVE AMENDMENT
STAFF Tammy Hilton DATE 6/25/99
Modify median at entrance North & South of Gateway

NOTE:
ALL STRIPING SHALL BE THERMOPLASTIC PER F.D.O.T. SPECIFICATIONS MINIMUM THICKNESS 90 MILS.

LEGEND
- EXISTING MEDIAN PLANTER AREA (CURBS REMOVED)
- 14.60' EXISTING ELEVATION

PETITION NO Sand + Sea
DATE SUBMITTED 6/25/99
EXHIBIT NO layout (2 of 2)

CARNEY-NEUMANN, INC. LC#770
11811 U.S. HIGHWAY 1, SUITE 120 PALM BEACH GARDENS, FL 33408 TEL: (561)622-1300 FAX: (561)622-1428
3050 BISCAYNE BLVD. SUITE 200 MIAMI, FL 33139 TEL: (305)576-9900 FAX: (305)576-9900
4101 N. ANDREWS AVE., SUITE 213 FORT LAUDERDALE, FL 33308 TEL: (954)565-0630 FAX: (954)565-3624

THIS DRAWING NOT VALID UNLESS SEALED WITH EMBOSSED SEAL.

DATE:	4-30-99			
DWG BY:	JLG			
CHKED BY:	D.O.C.	6/18/99	JLG	D.O.C.
P.B.:		DATE	BY	SIGNED

REVISED PER TRAFFIC DEPT. REVIEW
REVISION

PROPOSED ACCESS ROAD IMPROVEMENTS
SAND AND SEA VILLAGE MOBILE HOME COMMUNITY
PALM BEACH COUNTY FLORIDA

SCALE:	1" = 20'
PROJECT No.	85 - 311B
SHEET No.	1 of 1
FILE No.	85 - 311B